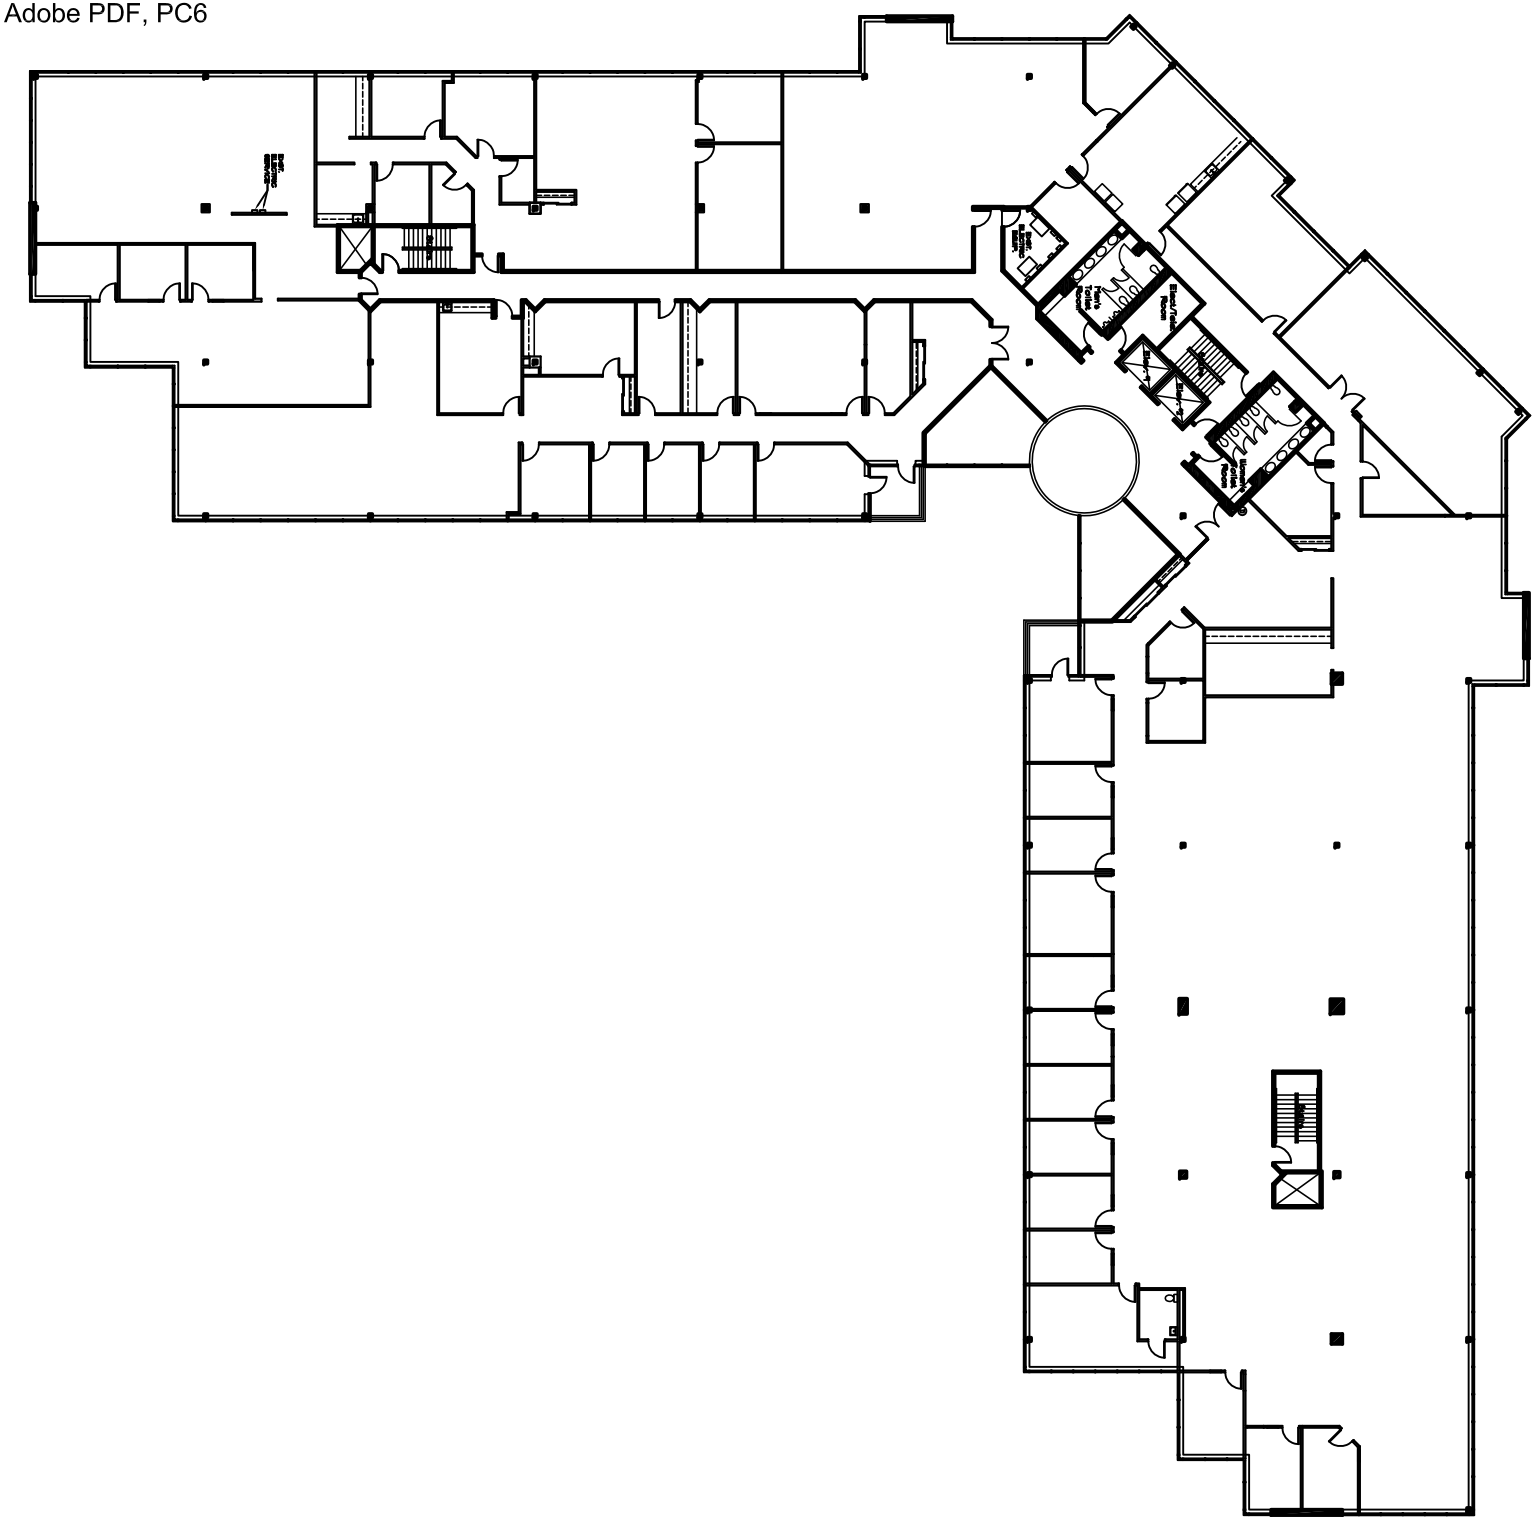K:\Drawings\C. B. Richard Ellis\New Jersey\51 Haddonfield Road, Cherry Hill, NJ\2nd Floor\51 Haddonfield 2nd Floor email format.dwg,
4/5/2012 2:45:26 PM, Adobe PDF, PC6